



This drawing is copyright and may not be reproduced in whole or part without written authority. Do not scale off this drawing.


REVISIONS
 REV A NORTH ELEVATION FIRE EXIT DOORS UPDATED 10/06/01 GH
 REV B UPDATED FOR CHANGE ORDER 006 28/06/01 GH
 REV C CENTRE WALLING REMOVED FROM LARGE WINDOWS 28/06/01 MJ
 REV D AS BUILT 28/06/01 GH

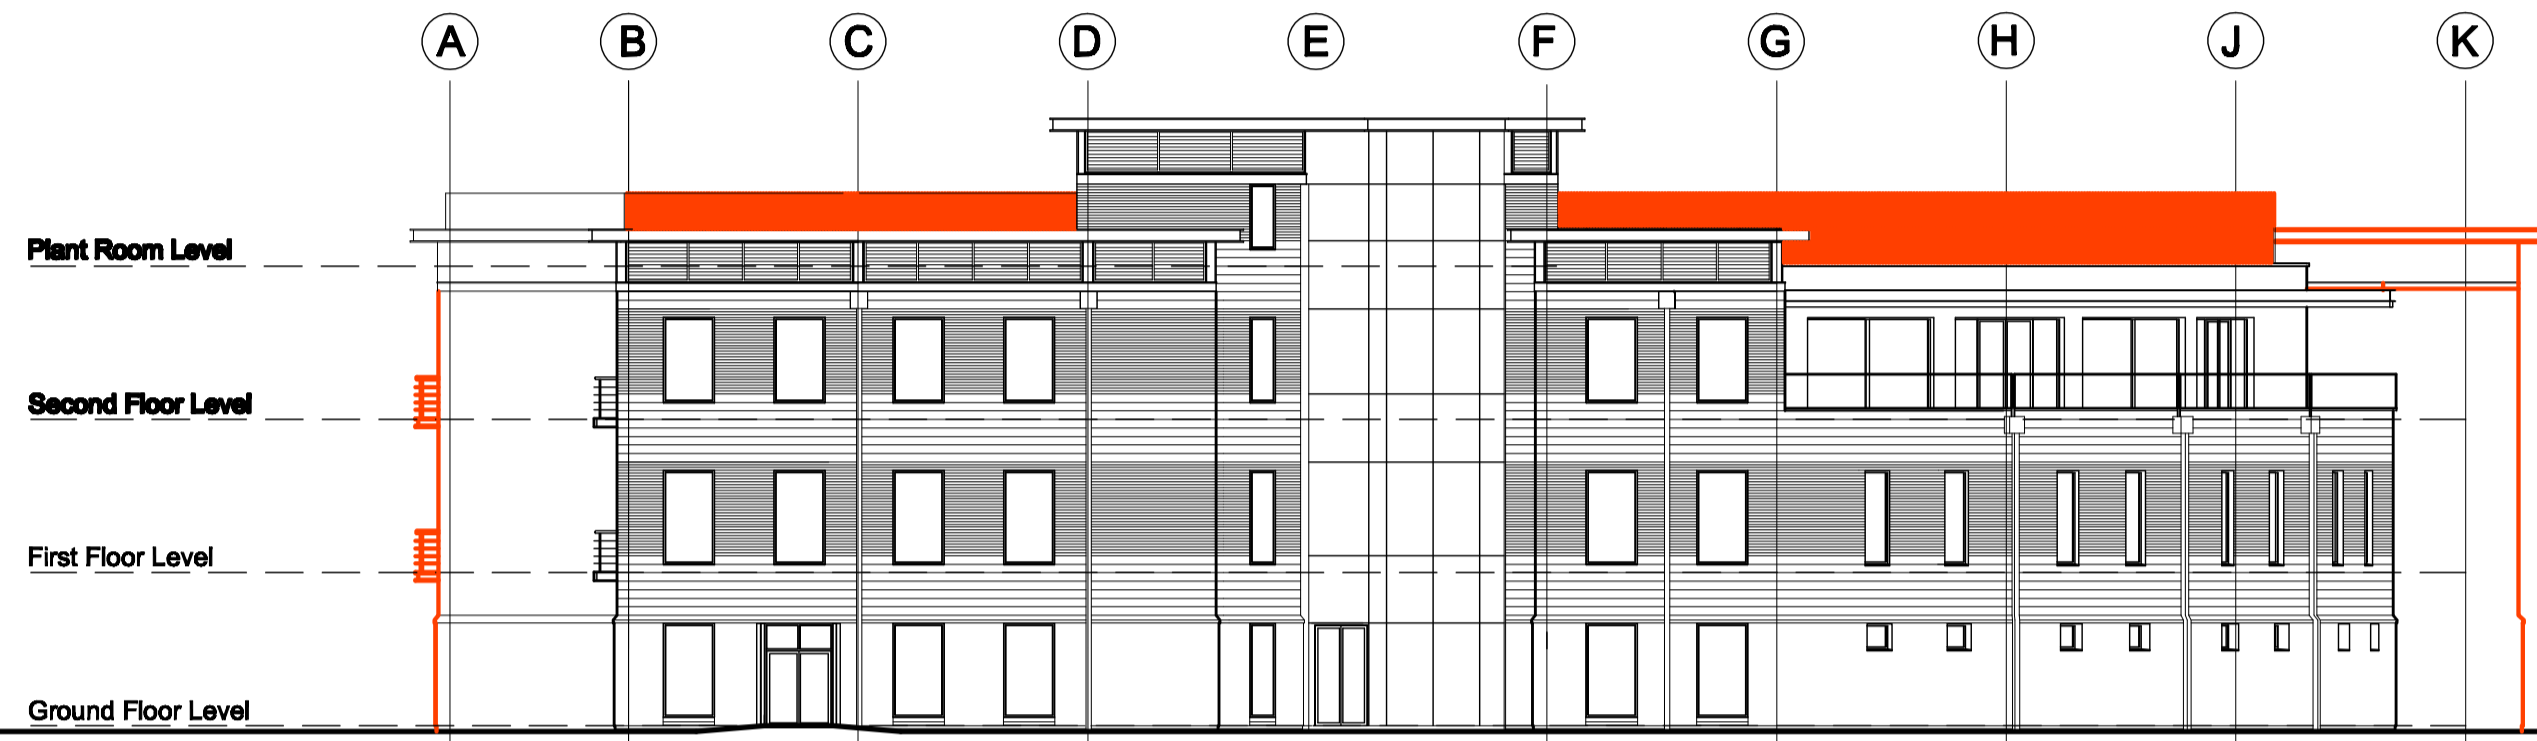


West Elevation, along Grid Line 6

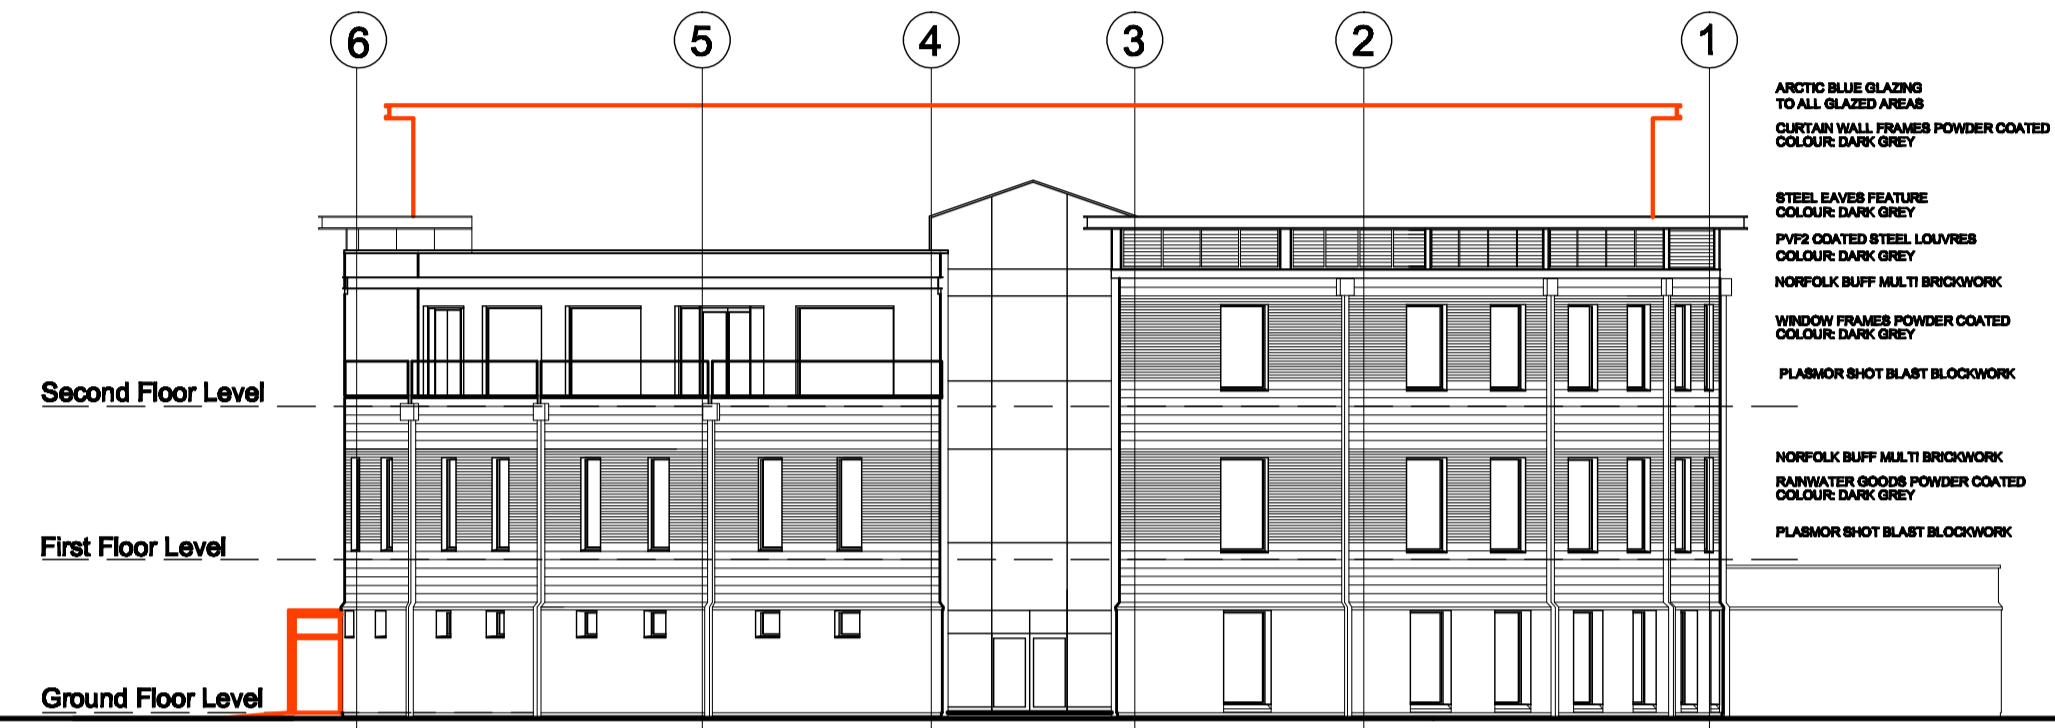

South Elevation, along Grid Line L

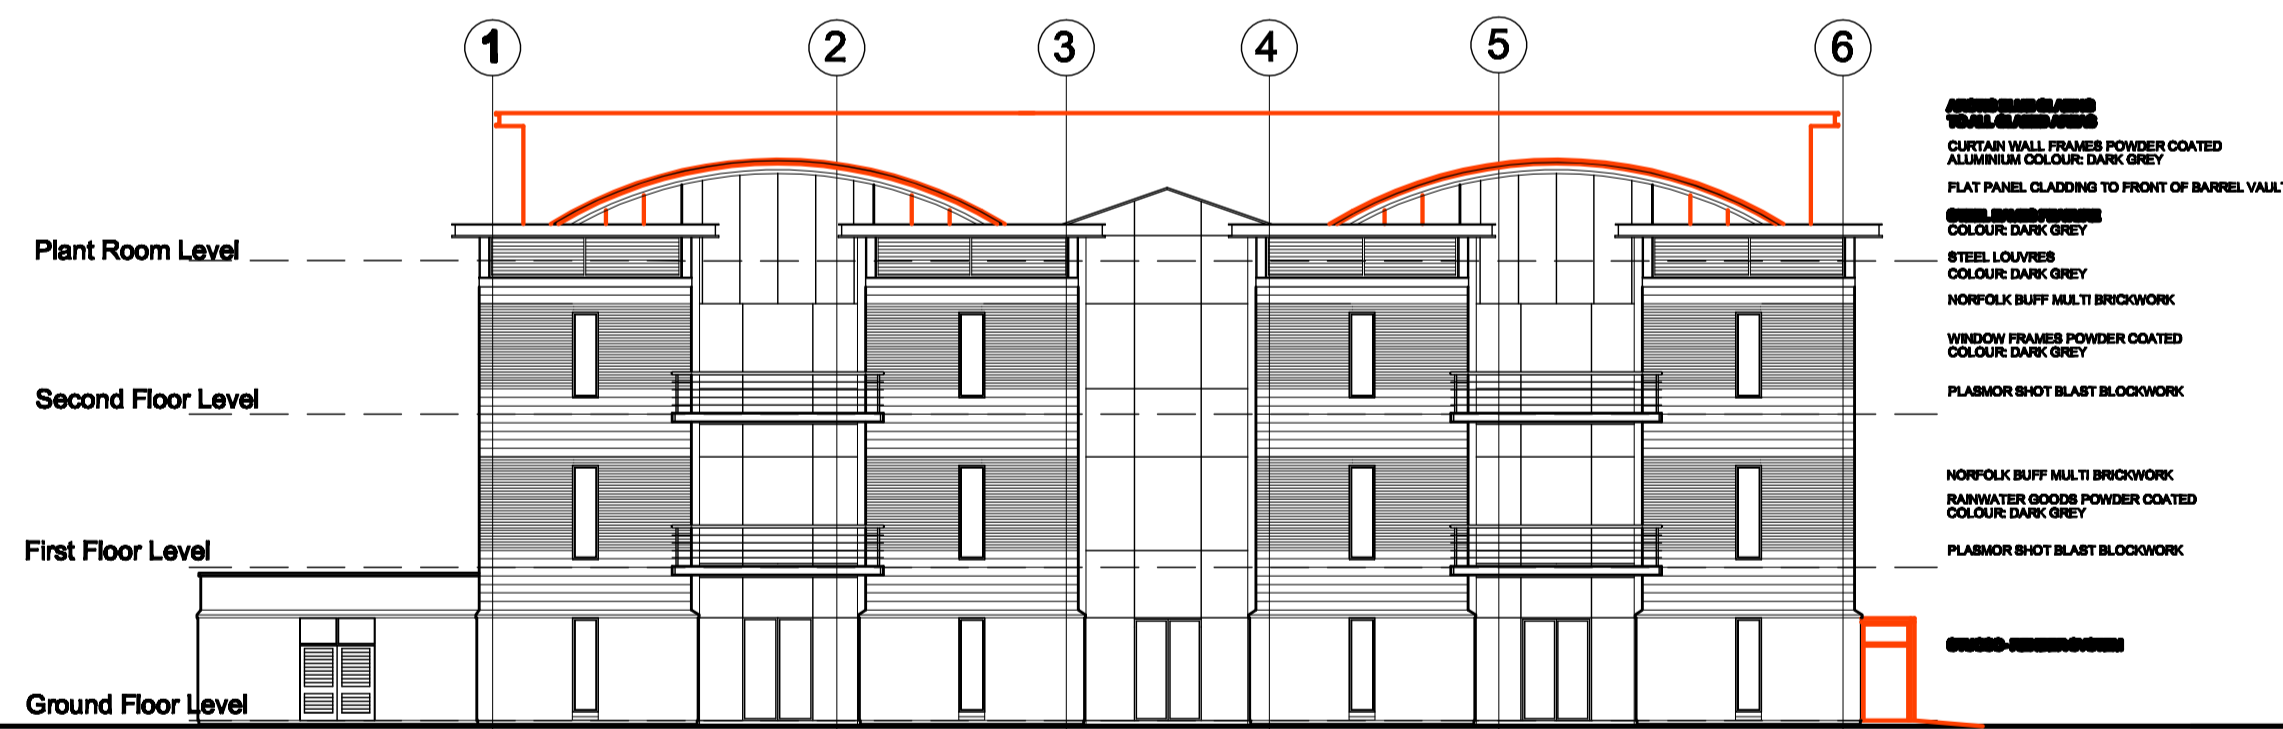

North Elevation, along Grid Line A

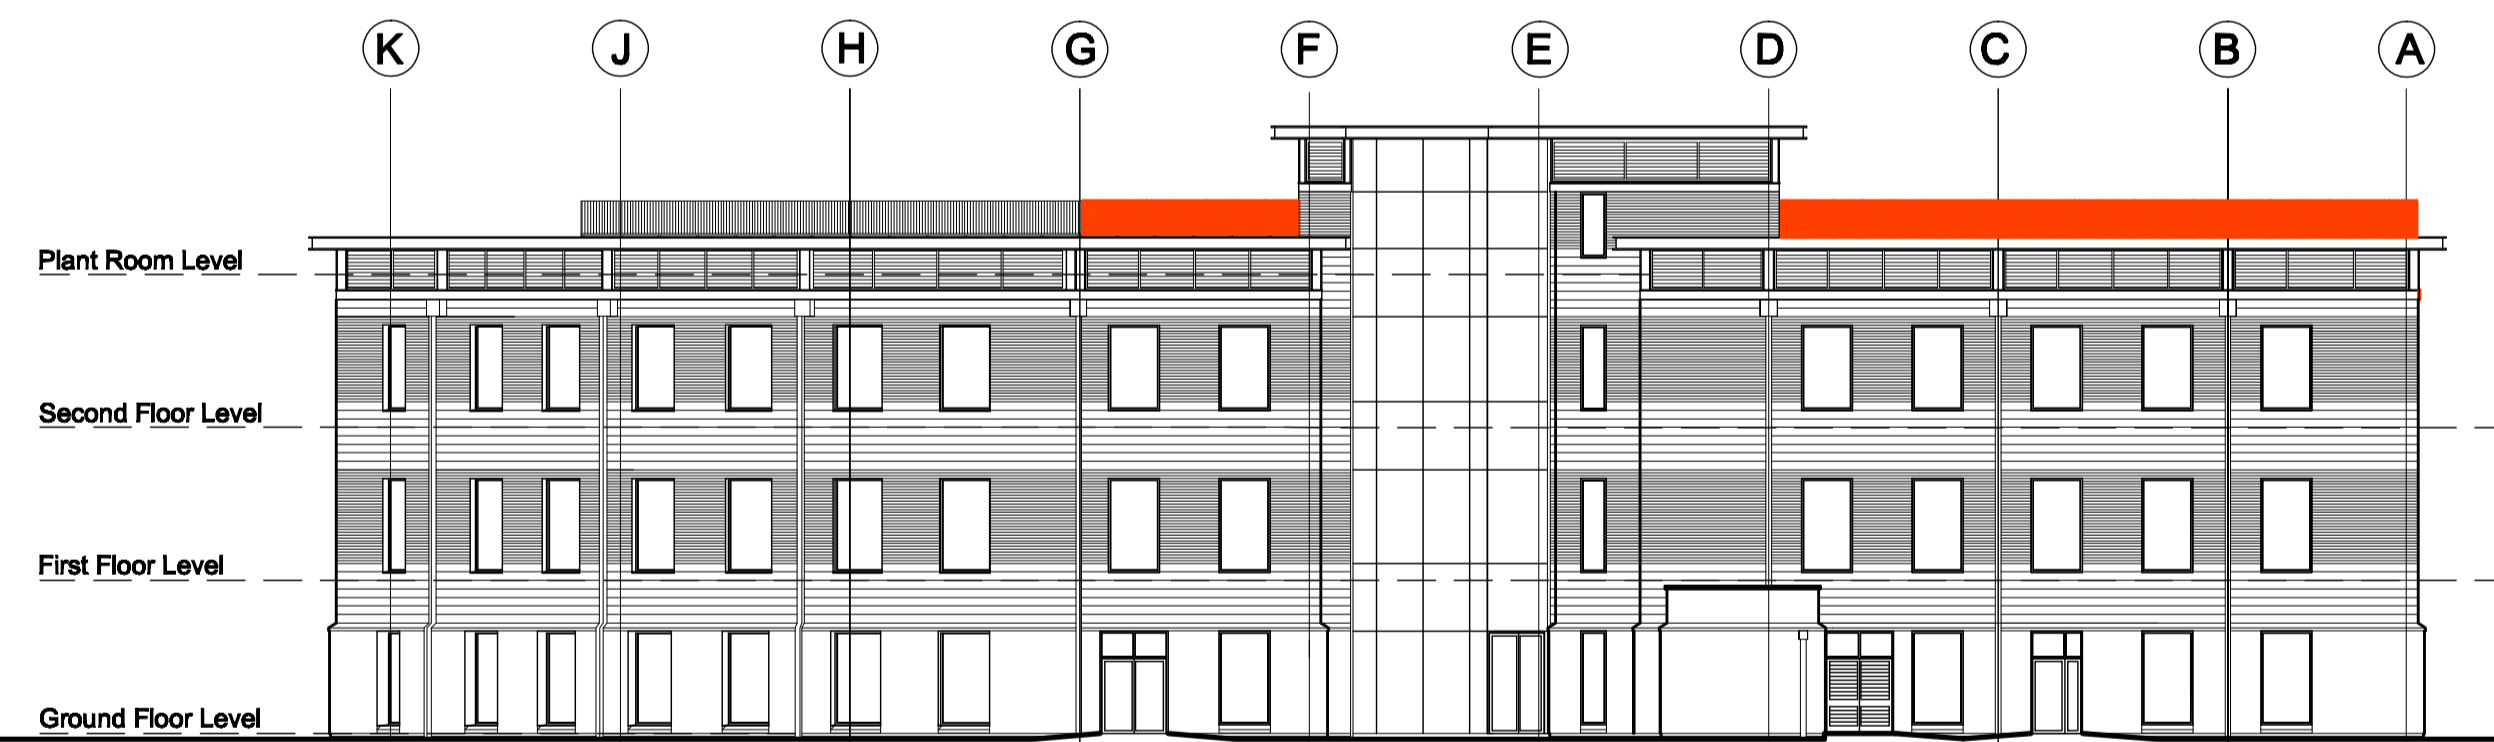

East Elevation, along Grid Line 1

**AS BUILT
DRAWING**

PROJECT
 PROPOSED OFFICE HEADQUARTERS
 DUNSLOW ROAD
 SCARBOROUGH

CLIENT
 HARRISON DEVELOPMENTS

TITLE
 ELEVATIONS

JOB NO	DRAWING NO	REVISION
5411	1003	D
DATE	SCALE	DRAWN
Nov 2000	1:200 @ A1	gary

OLD FILE REFERENCE
 J:\PROJECTS\5001-6000\5411

24 ST JOHN'S NORTH
 WAKEFIELD WF1 3QA
 Tel: (01924) 291800
 Fax: (01924) 290072
 Email: name@harrispartnership.com

Offices also at:
 Manchester
 Newport Pagnell



ARCHITECTS

PROJECT MANAGERS • INTERIOR DESIGNERS