


This drawing is copyright and may not be reproduced in whole or part without written authority. Do not scale off this drawing.

**REVISIONS**

REV A: CHANGE ORDERS 001,004,005 ADDED	01:06:01 GH
REV B: CHANGE ORDER 008,010,011 ADDED	13:07:01 GH
REV C: GAZED DOOR TO GYM AS BUILDING CONTROL COMMENTS	01:08:01 GH
REV D: REVISED TO CHANGE ORDERS 15,16	30:08:01 GH
REV E: REVISED TO CHANGE ORDER 16A	22:10:01 GH
REV F: REVISED LINE OF LOCKER/LOBBY WALL 01:11:01 GH	
REV G: REVISED TO CHANGE ORDER 22	22:10:01 GH
REV H: Internal double doors revised, platform added in camera room, fridges removed in kitchen	13:02:02 MG
REV I: Lobby added to door N 05	17:01:02 MG
REV J: Layout to gym change / showers revised	24:01:02 MG
REV K: ADDED CHANGING AREA IN KITCHEN	30:01:02 GH
REV L: Glass wall added to RM. N's 42 & 42a, wall between RM. N's 5/6 & 30 revised, folding partition added in RM. N 5 / 6	05:02:02 MG
REV M: REVISED TO CHANGE ORDER 36	13:02:02 GH
REV N: ADDED DISHWASH/OFFICE, COSHH	07:03:02 GH
REV P: AS BUILT	21:06:02 GH

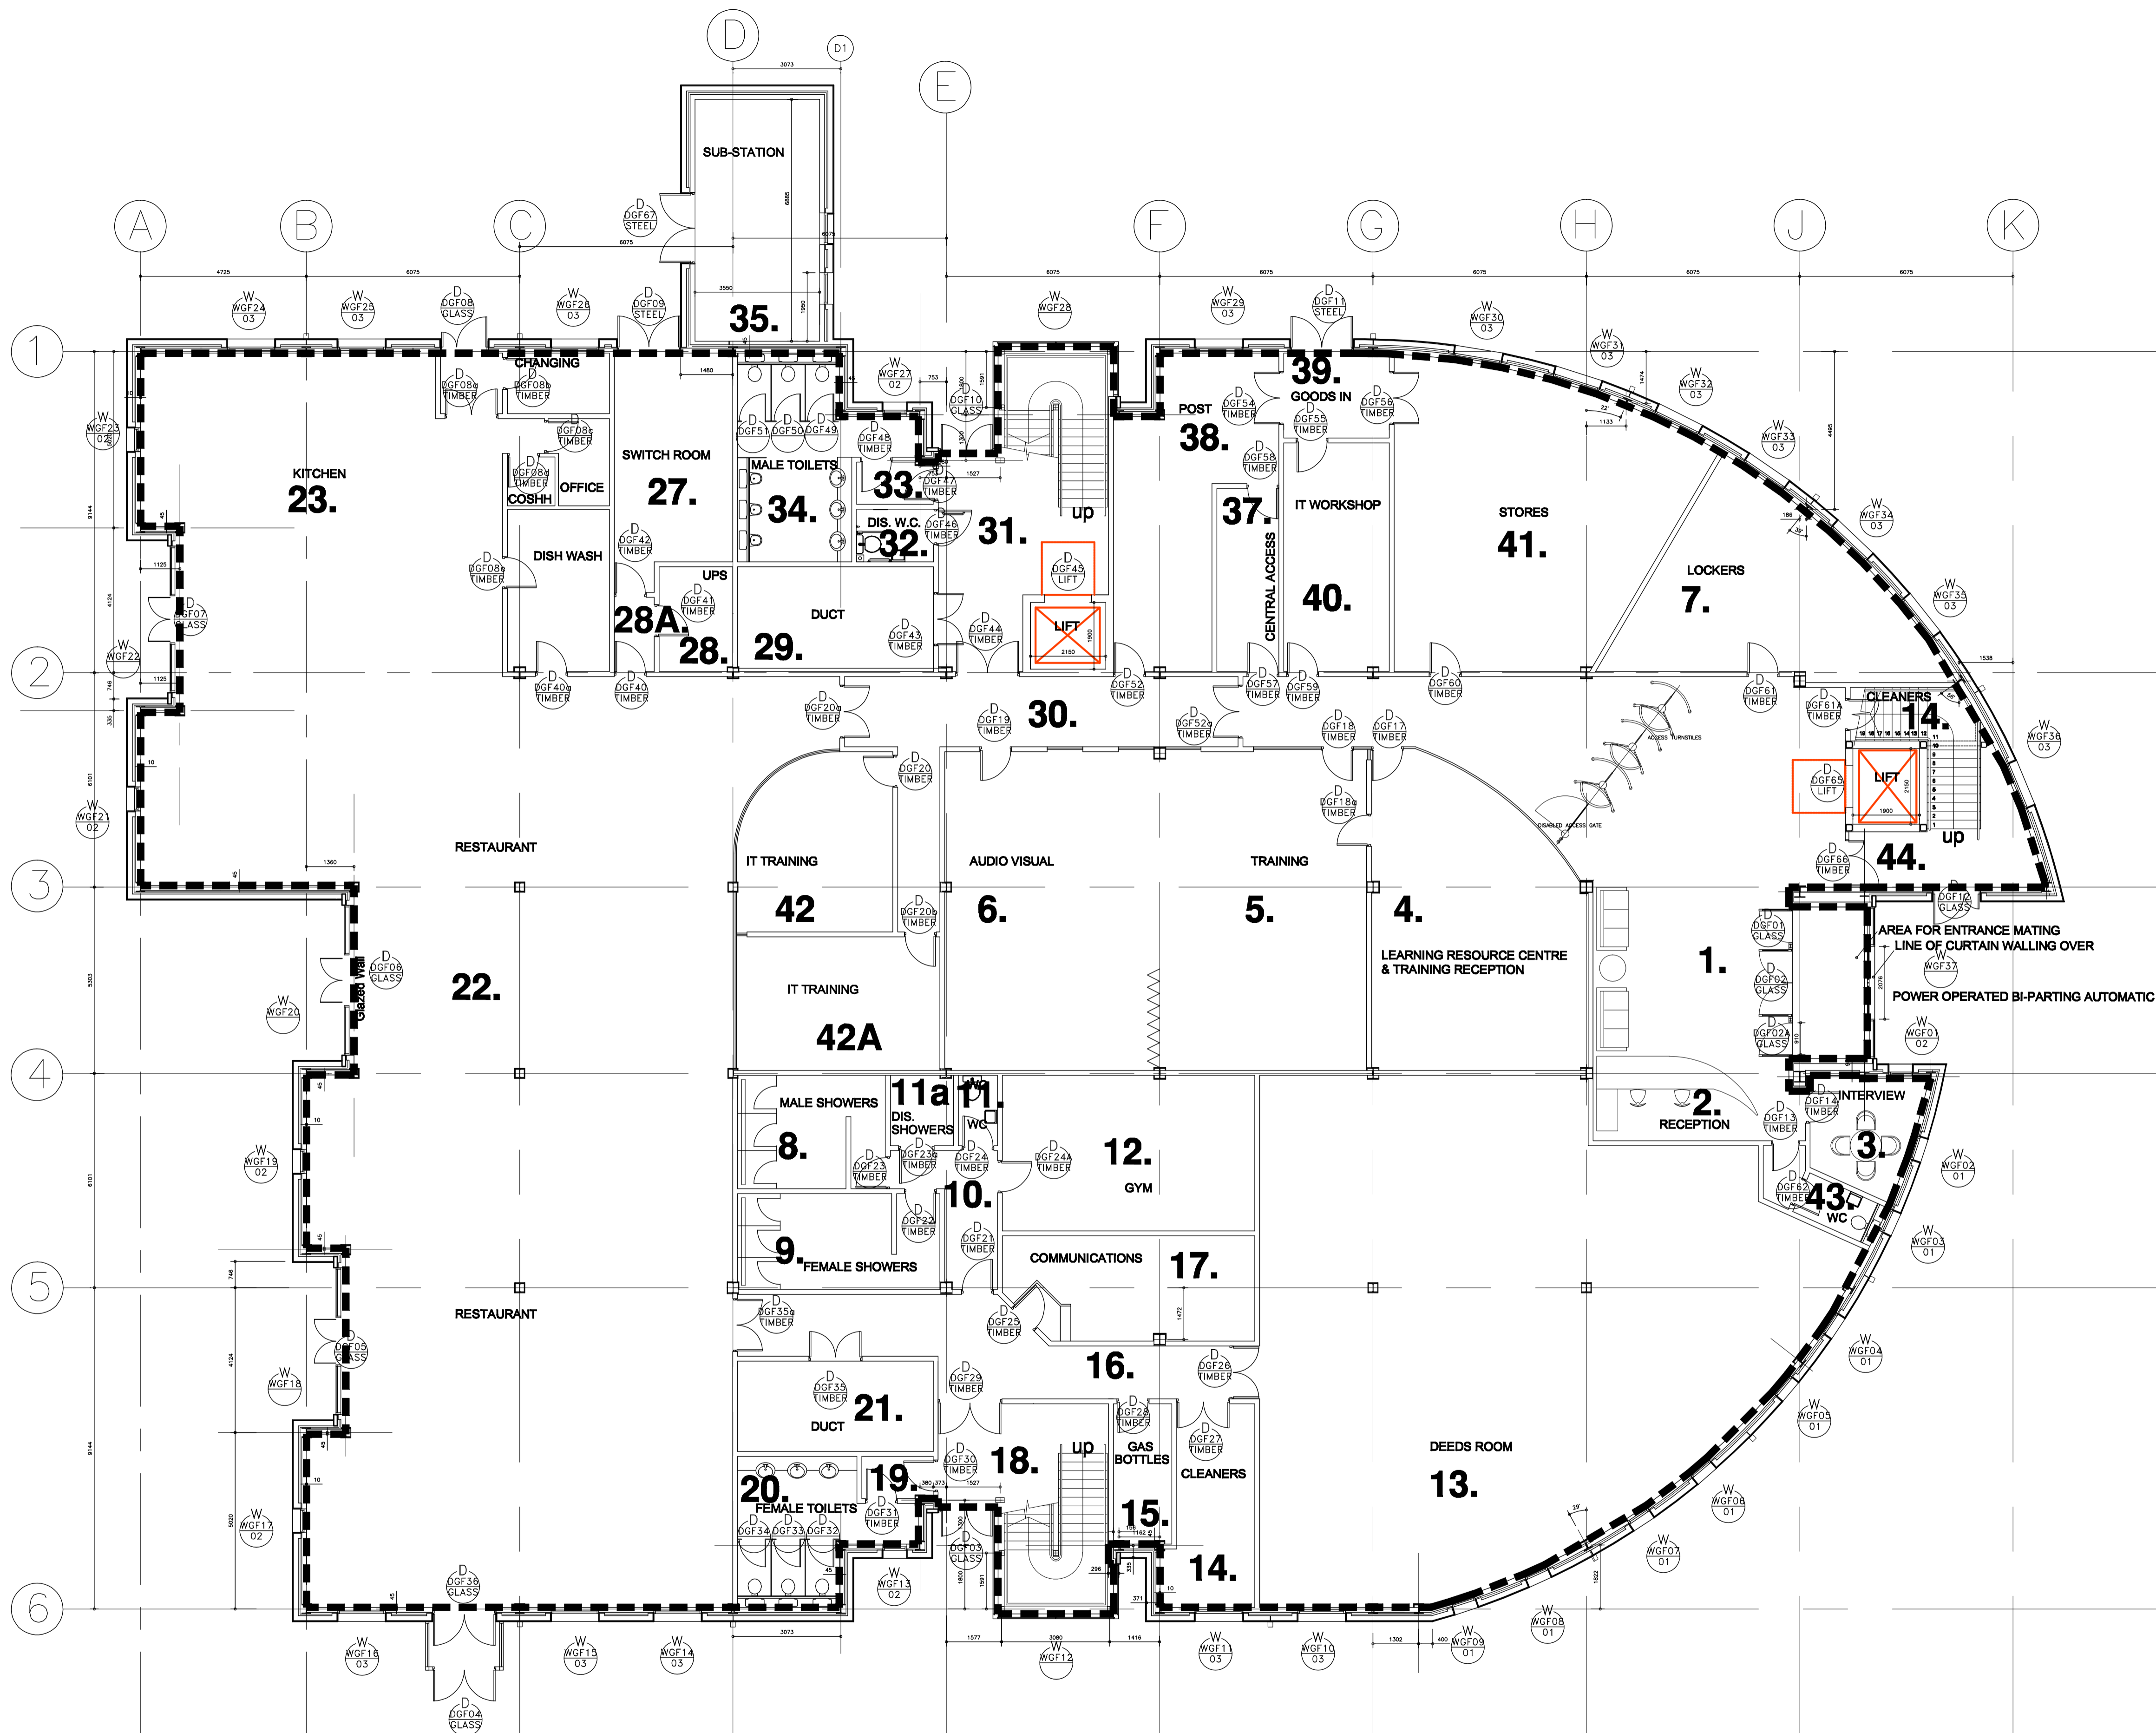

FLOOR AREA 1571 SQM / 16,910 SQFT

**AS BUILT DRAWING**

PROJECT  
 PROPOSED OFFICE  
 HEADQUARTERS DEVELOPMENT  
 DUNSLOW ROAD  
 SCARBOROUGH

CLIENT  
 S. HARRISON DEVELOPMENTS LTD

TITLE  
 GROUND FLOOR PLAN

JOB NO	DRAWING NO	REVISION
5411	1005	N
DATE	SCALE	DRAWN
Feb 2001	1:100 @ A1	Michaela

GRID FILE REFERENCE  
 J:\project\5001-6000\5411\construction

24 ST JOHN'S NORTH  
 WAKEFIELD WF1 3QA  
 Tel: (01924) 291800  
 Fax: (01924) 290072  
 Email: info@harrispartnership.com

Office also at:  
 Manchester  
 Newport Pagnell

**THE HARRIS PARTNERSHIP**

**ARCHITECTS**

PROJECT MANAGERS • INTERIOR DESIGNERS