


This drawing is copyright and may not be reproduced in whole or part without written authority. Do not scale off this drawing.

REVISIONS	
REV AMENDED TO CHANGE ORDER 014	30/07/01 GH
REV BIROOM N°s 48a & 48b ADDED	12/01/02 MG
REV CLAYOUT REVISED TO RM N°s 48a & 48b	17/01/02 MG
REV CLAYOUT REVISED TO RM N°s 48a & 48b	06/03/02 GH
REV E:20 FIRE DOORS ADDED TO CORRIDORS:20:03:02	GH
REV F:AS BUILT	21/06/02 GH

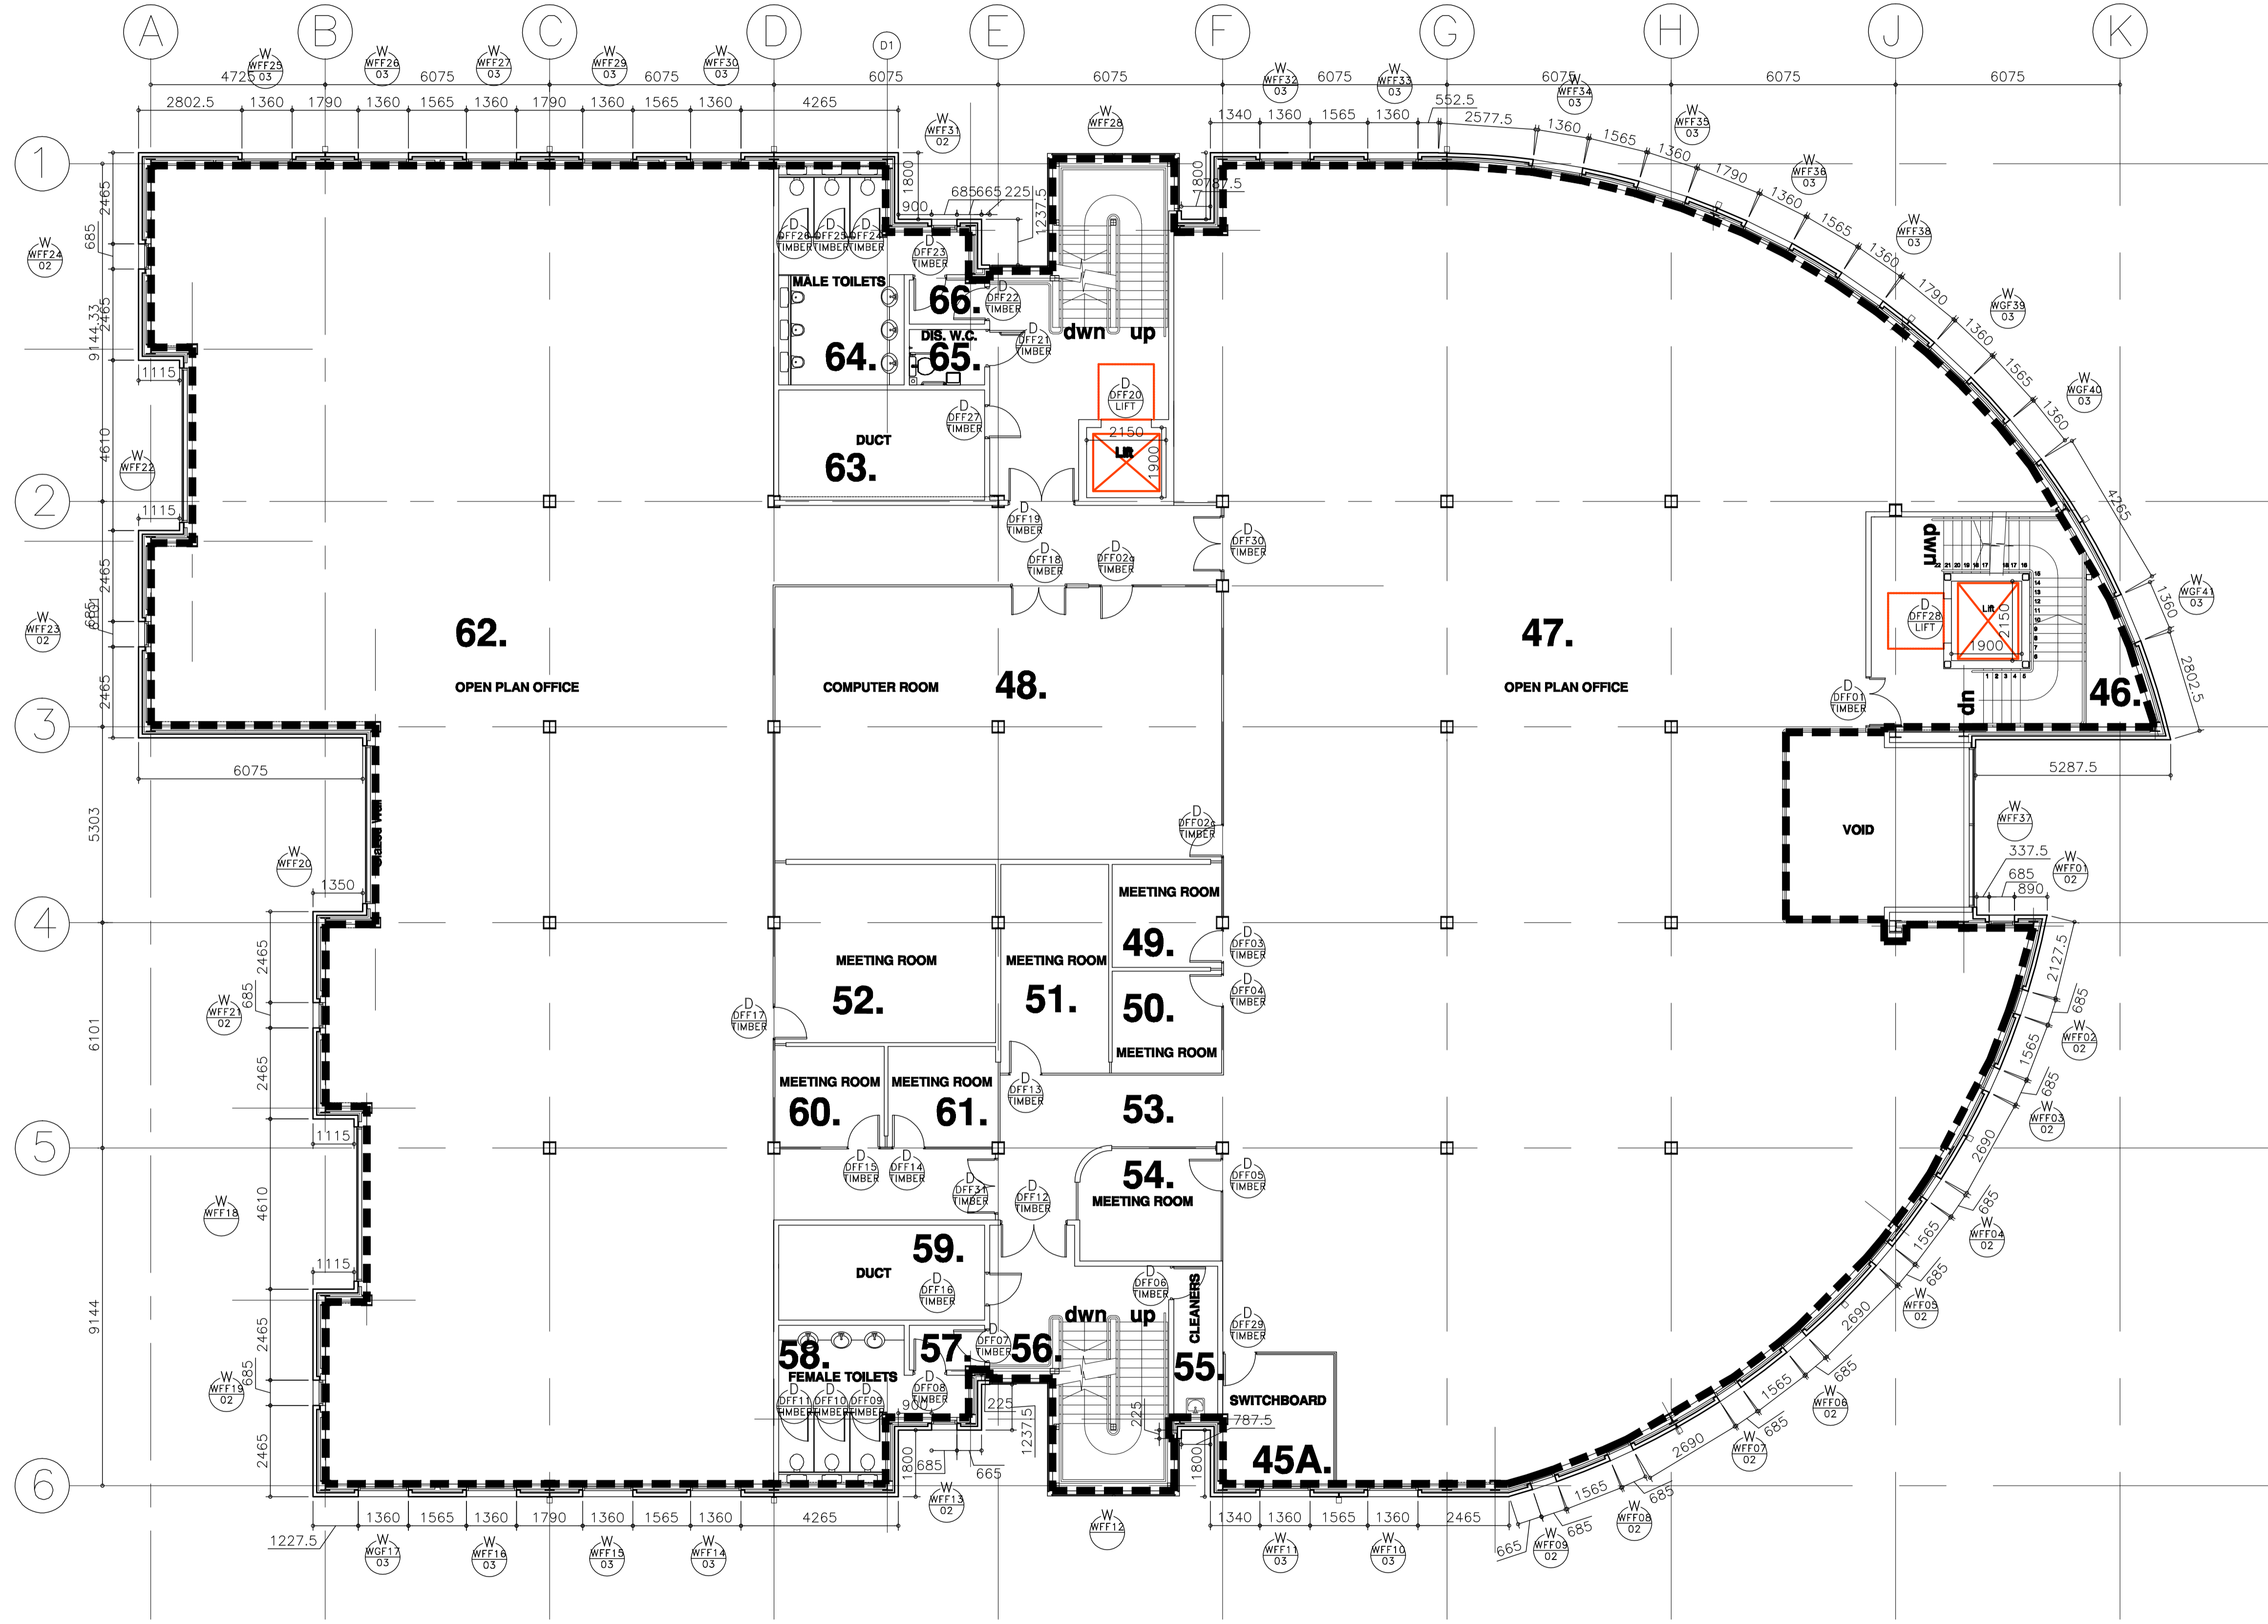

FLOOR AREA 1548 SQM / 16,663 SQFT

AS BUILT DRAWING

PROJECT
PROPOSED OFFICE HEADQUARTERS DEVELOPMENT
 DUNSLOW ROAD
 SCARBOROUGH

CLIENT
S. HARRISON DEVELOPMENTS Ltd.

TITLE		
FIRST FLOOR PLAN		
JOB NO	DRAWING NO	REVISION
5411	1006	F
DATE	SCALE	DRAWN
Feb. 2001	1:100 @ A1	Michaela

OLD FILE REFERENCE
 j:\projects\5001-6000\5411\construction

24 ST JOHN'S NORTH
 WAKEFIELD WF1 3QA
 Tel: (01924) 291800
 Fax: (01924) 290072
 Email: name@harrispartnership.com



Offices also at:
 Manchester
 Newport Pagnell

ARCHITECTS

PROJECT MANAGERS • INTERIOR DESIGNERS