This drawing is copyright and may not be reproduced in whole or part without written authority
Do not scale off this drawing

REVISIONS

REV A:REVISED ROOF OVER FRONT STAIRAND ROOF OVER EXTERNAL PLANT ROOM 21:03:01 GH
REV B:CAT LADDER/FLOOR SLAB AMENDED IN LINE WITH SHC COMMENTS 23:03:01 GH
REV C:UPDATED PLANT ROOM ROOF LAYOUT 12:04:01 GH
REV D:DOOR AND PARTITION ADDED TO HEAD OF STAIR TO SBS REQUIREMENTS 19:03:02 GH
REV E:AS BUILT 21:06:02 GH

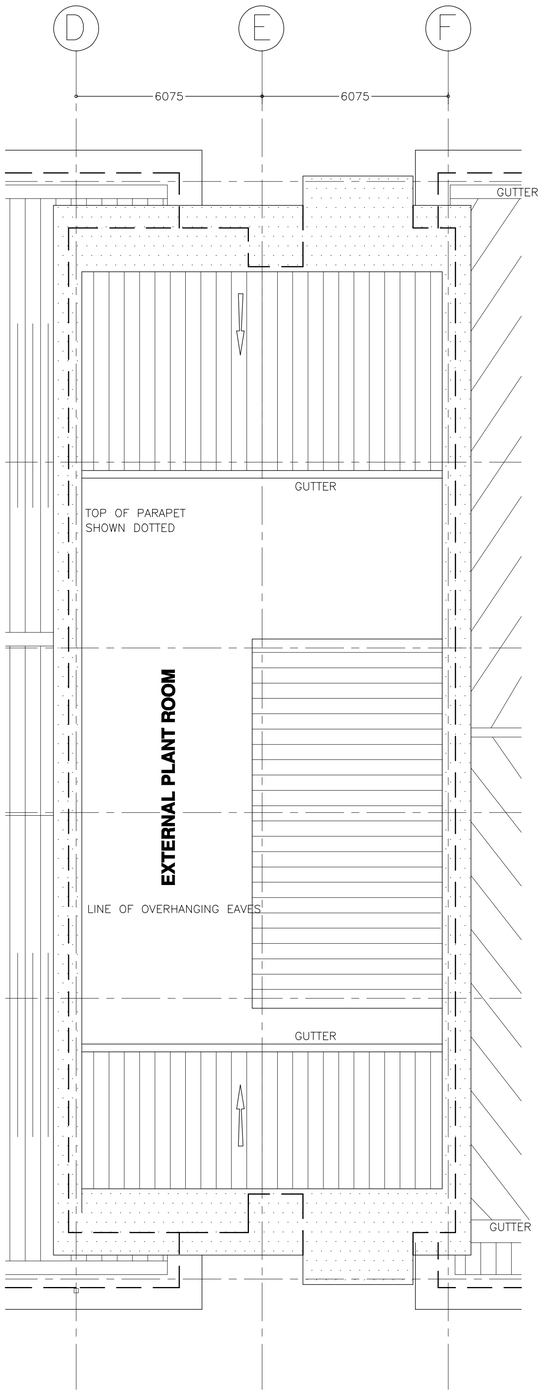

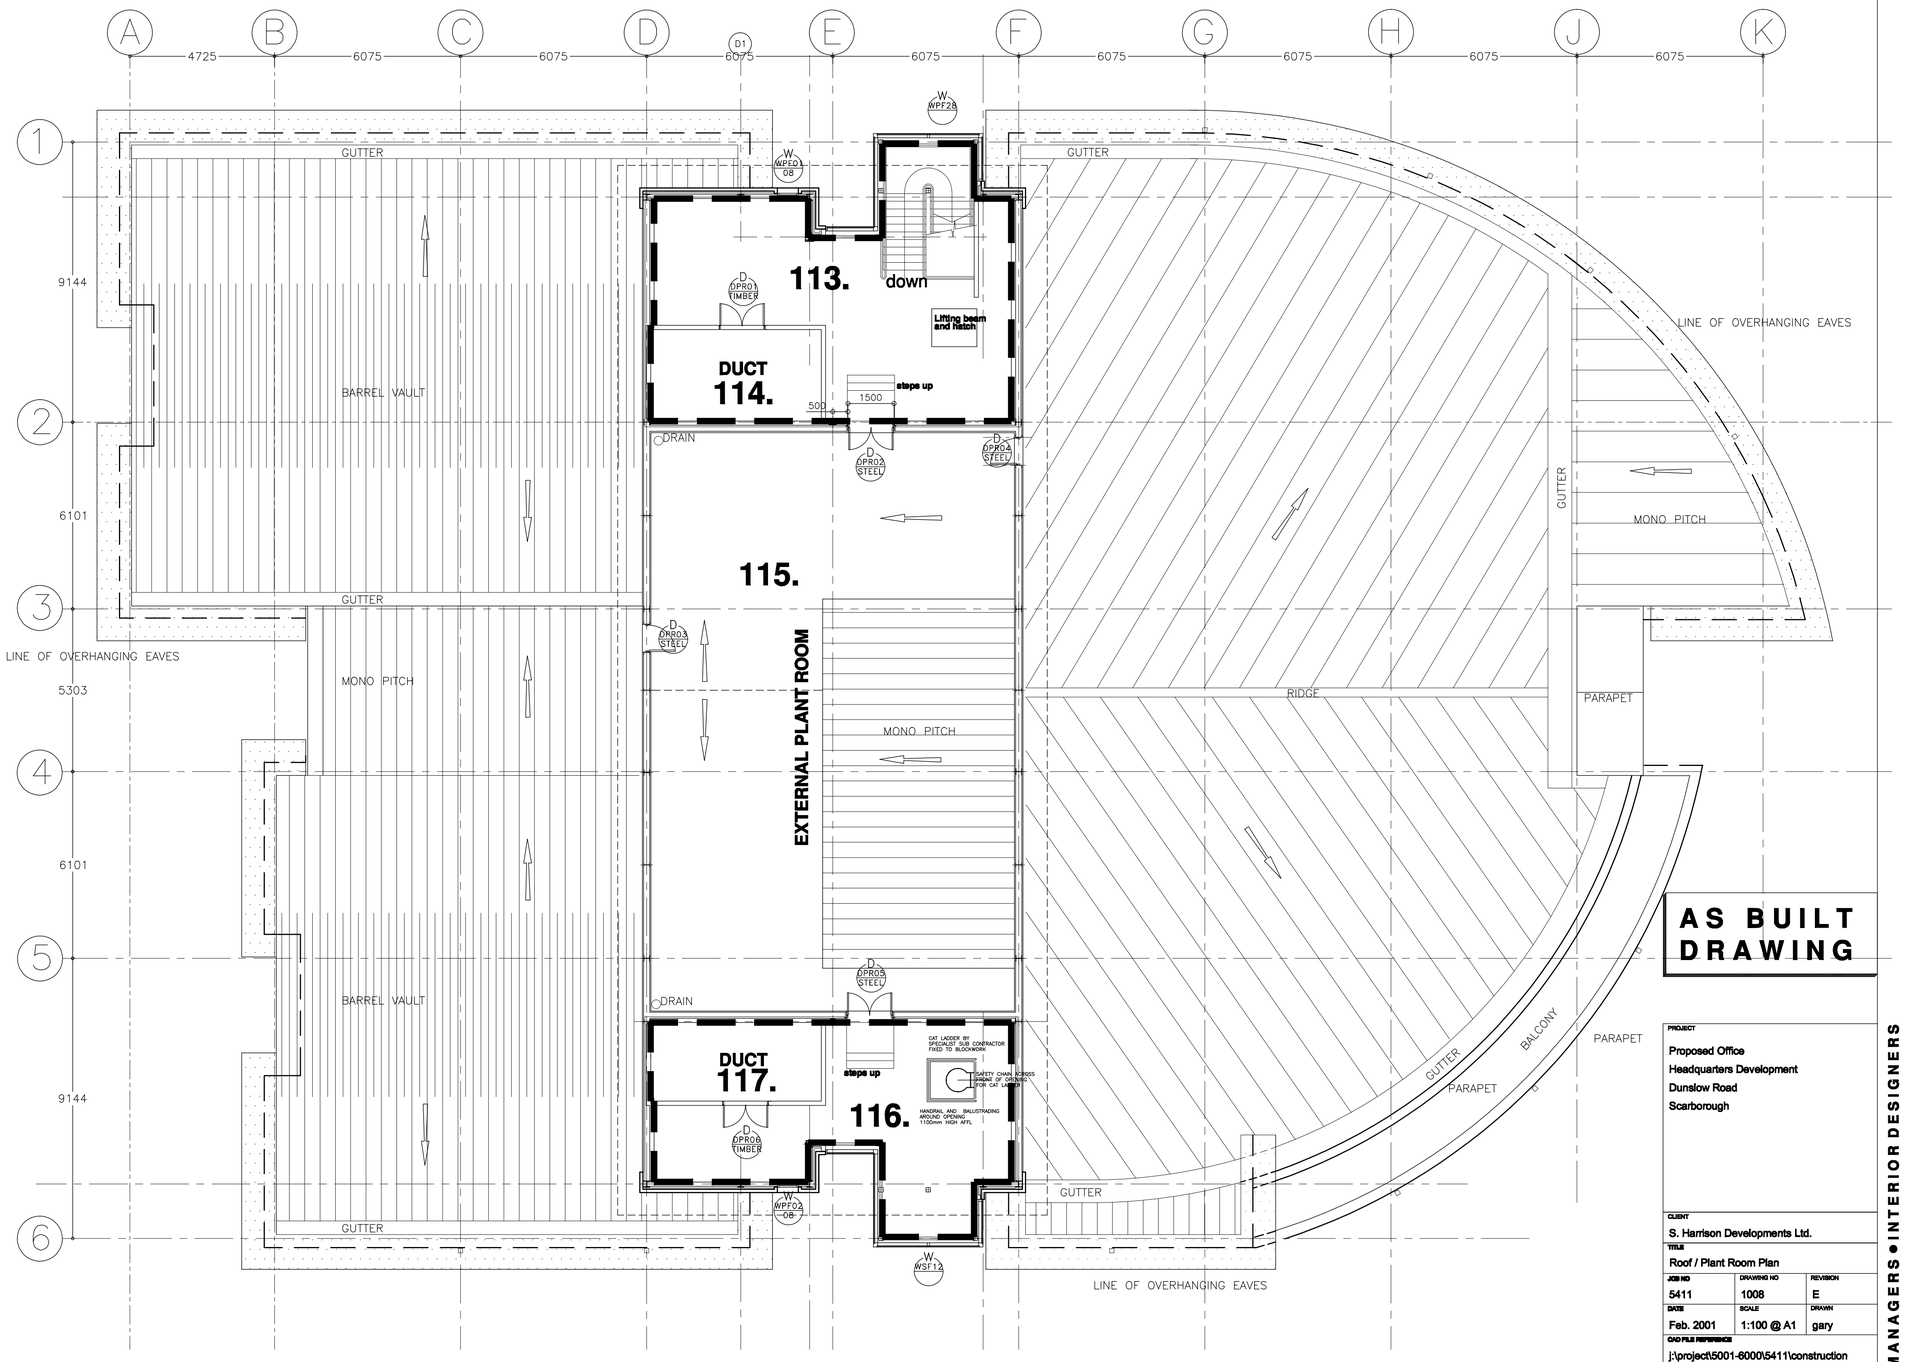

PLANT ROOM ROOF PLAN

PLANT ROOM FLOOR PLAN

FLOOR AREA 150 SQM / 1,614 SQFT

AS BUILT DRAWING

PROJECT
Proposed Office
Headquarters Development
Dunslow Road
Scarborough

CLIENT
S. Harrison Developments Ltd.

TITLE
Roof / Plant Room Plan

JOB NO	DRAWING NO	REVISION
5411	1008	E
DATE	SCALE	DRAWN
Feb. 2001	1:100 @ A1	gary

CAD FILE REFERENCE
j:\project\5001-6000\5411\construction

24 ST JOHNS NORTH
WAKEFIELD WF1 3QA
Tel. (01924) 291800
Fax. (01924) 290072
Email: gary @harrispartnership.com
Offices also at:
Manchester
Newport Pagnell
THE HARRIS PARTNERSHIP
ARCHITECTS • PROJECT MANAGERS • INTERIOR DESIGNERS